

South Carolina Department of Health and Environmental Control
Office of Ocean and Coastal Resource Management
1362 McMillan Avenue, Suite 400
Charleston, South Carolina 29405

November 26, 2013
Permit Amendment Public Notice

Tristan & Callie Cordray, OCRM-12-175-E

The Department has received an application for a permit for the alteration of a critical area. The application was submitted pursuant to the Coastal Zone Management Act (Act 123) of 1977 South Carolina General Assembly. The application in brief, is described as follows:

LOCATION: On and adjacent to Penny Creek at 1197 River Road, Johns Island, Charleston County, South Carolina.
TMS: 311-00-00-043.

WORK: The permittee has requested an amendment to the issued permit. Specifically, the permittee is seeking authorization to keep the 8' x 20' floating jet that was installed in lieu of the 12.5' x 12.5', four-pile boatlift. The amendment is for AFTER-THE-FACT authorization for a floating jet dock at a private, recreational dock.

This public notice is being distributed to all known interested persons and agencies to assist in developing facts on which a decision by the Department can be based. Comments concerning the proposed work must be submitted in writing, setting forth sufficient detail to furnish a clear understanding of the reasons for support or opposition.

Comments regarding this application must be received by the Department on or before **December 6, 2013**. For more information, please contact:
Bill Eiser at 843-953-0237 or via email at eiserwc@dhec.sc.gov.

NOTE: Plans depicting the proposed work are available and will be provided upon receipt of a written request or may be viewed on the Department website at www.scdhec.gov/environment/ocrm/public_notice.htm.

ADJACENT OWNERS

1. SANDBLAST INC
2690 SWYGERT LANE
JOHNS ISLAND SC 29455
2. ALAN D HORRES
SUZANNE S HORRES
1205 RIVER RD
JOHNS ISLAND SC 29455

DATE: OCTOBER 26, 2013
SCALE: 1"=60'

THE SHREC-OCRM CRITICAL LINE
AS SHOWN WAS APPROVED BY
WILLIAM C EISER ON JUNE 21, 2012

TRACT D
TMS 311-00-00-044
SANDBLAST INC


Marsh
1.31 ACRES
555' (NEWLY BUILT)

TRACT 1-A
TMS 311-00-00-042
ALAN D HORRES, JR
SUZANNE S HORRES

ACTIVITY: PRIVATE RECREATION DOCK
AS BUILT DRAWING
1197 RIVER ROAD

IN: PENNY CREEK
NEAR: JOHNS ISLAND
COUNTY OF: CHARLESTON
STATE OF: SOUTH CAROLINA
PREPARED FOR: CALLIE CORDRAY

SHEET 1 OF 2
DATE: OCTOBER 26, 2013 058-12

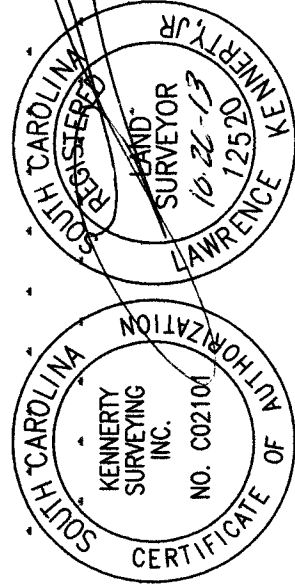

ATF
amendment
OCRN-12-175-C



SCALE: 1"=80'

